
M-35

FED. ROAD DIST. NO.	STATE	FED. AID PROJ. NO.	SHEET NO.	TOTAL SHEETS
4	WIS.	758-C(1)	1	61

DIVISION JOB NO. 6424

INDEX OF SHEETS

SHEET NO. 1 TITLE
SHEET NO. 2-2A TYPICAL CROSS SECTIONS
SHEET NO. 3-3A ESTIMATE OF QUANTITIES
SHEET NO. 3.1 MISCELLANEOUS QUANTITIES
SHEET NO. 7-9 RIGHT OF WAY PLAT
SHEET NO. 10-19 PLAN AND PROFILE STA. 401+11 TO STA. 670+00
SHEET NO. 20-25 STANDARD DETAILS
SHEET NO. 26 DRAINAGE STRUCTURES
SHEET NO. 27-61 CROSS SECTIONS

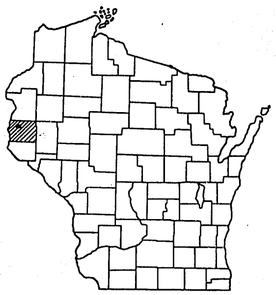

STATE OF WISCONSIN

STATE HIGHWAY COMMISSION OF WISCONSIN

PLAN AND PROFILE OF PROPOSED


NEW RICHMOND — BLOOMER ROAD

ST. CROIX COUNTY

FEDERAL AID PROJECT NO. 758-C(1)

BEGINNING AT A POINT NEAR THE SOUTHEAST CORNER OF SEC. 30, T. 31 N., R. 16 W. AND EXTENDING EASTERLY TO A POINT APPROXIMATELY 419.5 FEET NORTH OF THE SOUTHWEST CORNER OF SEC. 30, T. 31 N., R. 15 W.

SCALES
PLAN 1 IN. 100 FT.
PROFILE HOR. 1 IN. = 100 FT. VERT. 1 IN. = 10 FT.
CROSS SECTIONS HOR. 1 IN. = 5 FT. VERT. 1 IN. = 5 FT.

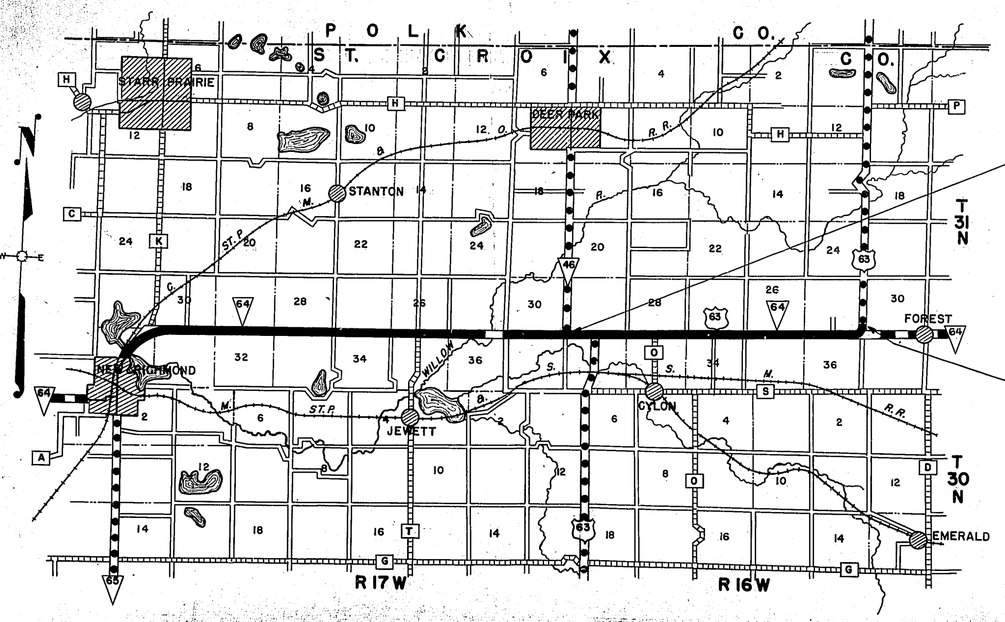

CONVENTIONAL SIGNS

STATE LINE
COUNTY LINE
TOWNSHIP OR RANGE LINE
SECTION LINE
NEW RIGHT OF WAY LINE
PRESENT RIGHT OF WAY LINE
WIRE FENCE (WOVEN, BARBED)
LOT LINE
CORPORATE OR CITY LIMITS
PROPERTY LINE — P.L. + 32.6
TRAVELED WAY OR P.E.
RAILROADS
BASE OR SURVEY LINE — 30

CULVERTS IN PLACE
CULVERTS REQUIRED
DROP INLET
POWER POLE
TELEPHONE OR TELEGRAPH POLE
RIGHT OF WAY MARKERS
REFERENCE STAKE FOR HUBS ONLY — 481.7 / 28.9
MARSH
HEDGE
TREES
GROUND ELEVATION — DATUM LINE — 73.9
GRADE ELEVATION — DATUM LINE — 75.16

LAYOUT

SCALE 0 — 1 — 2 MILES

TOTAL NET LENGTH OF CENTERLINE = 5.045 MI.

REVISED FOR SURFACING

RECOMMENDED FOR APPROVAL: DATE 8/16 1941
Frank Chase DESIGN ENGINEER — C. H. Blue CONSTRUCTION ENGINEER

APPROVED: DATE 8/18 1941
E. G. Rostiger STATE HIGHWAY ENGINEER

STATE HIGHWAY COMMISSION OF WISCONSIN
MADISON, WIS.

SURVEYOR R.S.M. NOTE BOOK L.L.
DIVISION COMPUTER R.S.M. M. O. CHECKER W.F.M.
DIVISION CHECKER M.V.M. CORRECT 5-8-41

CORRECT:
DATE 7/22/1941 W. F. Baumgartner DIVISION ENGINEER

RECOMMENDED FOR APPROVAL: DATE 7/24/1941
Frank Chase DESIGN ENGINEER — C. H. Blue CONSTRUCTION ENGINEER

APPROVED: DATE 6/4/1925
E. G. Rostiger STATE HIGHWAY ENGINEER

FEDERAL WORKS AGENCY
PUBLIC ROADS ADMINISTRATION

RECOMMENDED FOR APPROVAL:
[redacted] DISTRICT ENGINEER PUBLIC ROADS ADMINISTRATION FEDERAL WORKS AGENCY

APPROVED:
[redacted] COMMISSIONER PUBLIC ROADS ADMINISTRATION FEDERAL WORKS AGENCY

FIELD INVESTIGATED BY: F.C., H.J.T., O.J.H., J.S.P.

41

L 38

758C(1)