

P.R.A. DIVISION	PROJECT	SHEET NO.	TOTAL SHEETS
WIS. 5N	F011-1(30)	2	27

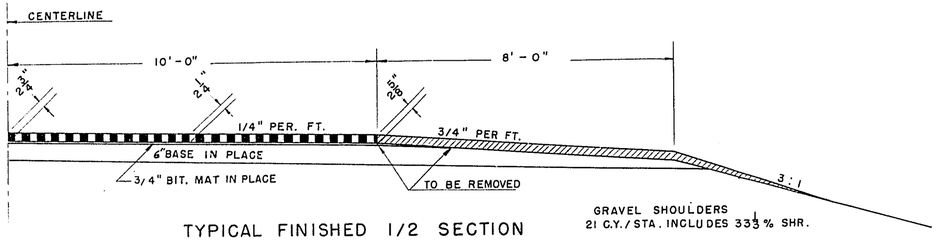


TYPICAL FINISHED 1/2 SECTION
STA. 27 + 40 TO STA. 319 + 60
STA. 349 + 65 TO STA. 398 + 82

GRAVEL SHOULDERS
21 C.Y./STA. INCLUDES 33⅓ % SHR.

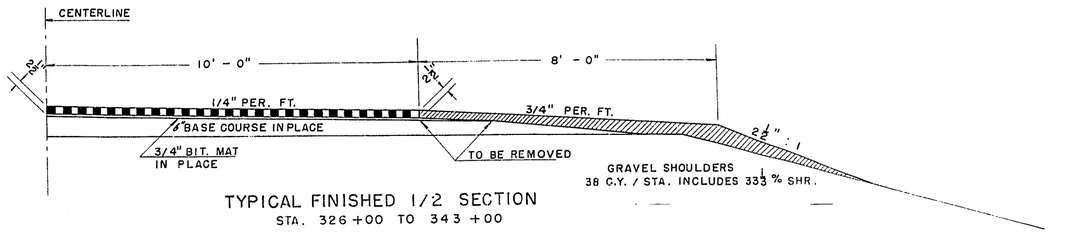


TYPICAL FINISHED 1/2 SECTION
STA. 326+00 TO 343+00

GRAVEL SHOULDERS
38 C.Y./STA. INCLUDES 33⅓ % SHR.

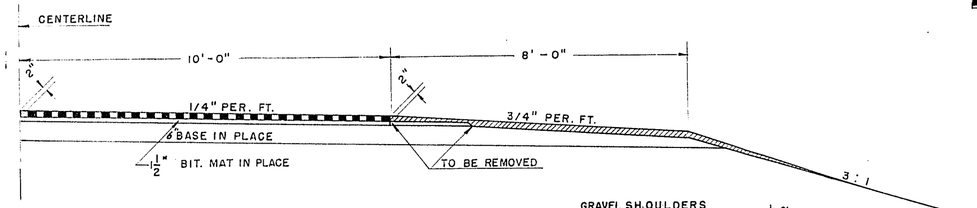


TYPICAL FINISHED 1/2 SECTION
STA. 403+40 TO 667+50


GRAVEL SHOULDERS
26.5 C.Y./STA. INCLUDES 33⅓ % SHR.

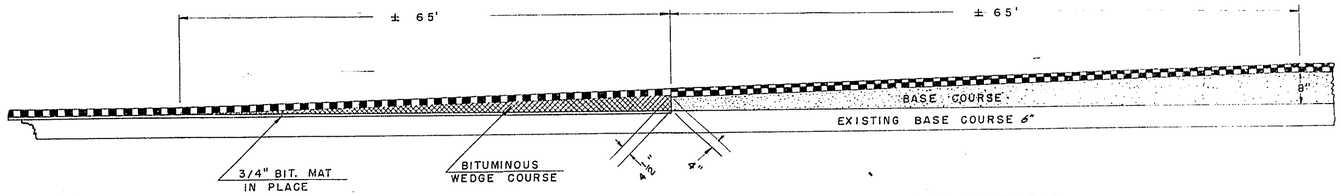

LONGITUDINAL SECTION FOR TRANSITION FROM BASE COURSE TO PAVEMENT

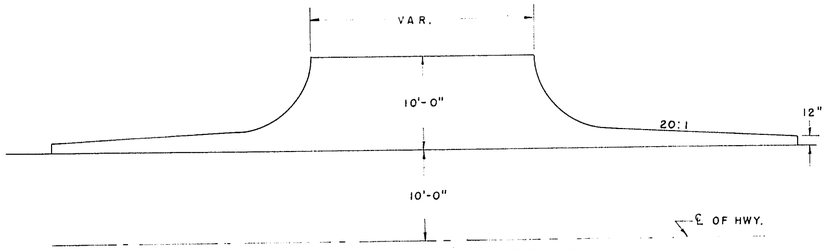


TYPICAL SECTION FOR SIDEROAD
(THIS MAY BE BLADE LAID)

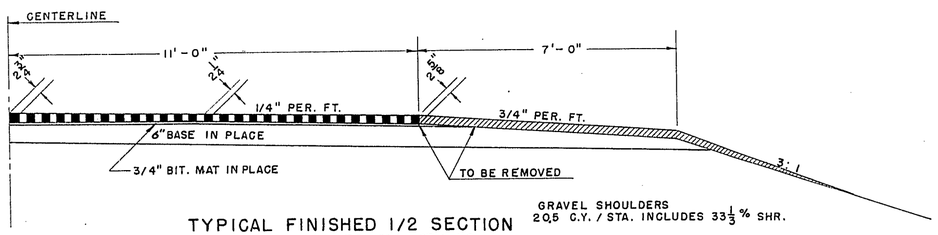

TYPICAL FINISHED 1/2 SECTION
STA. 0+00 TO STA. 27+40


GRAVEL SHOULDERS
20.5 C.Y./STA. INCLUDES 33⅓ % SHR.

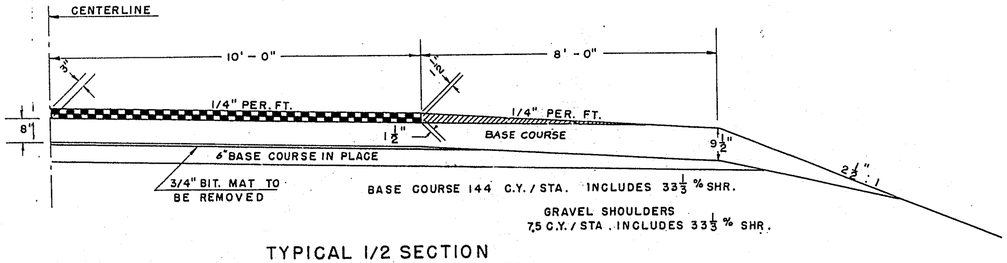

BASE COURSE 144 C.Y./STA. INCLUDES 33⅓ % SHR.

GRAVEL SHOULDERS
7.5 C.Y./STA. INCLUDES 33⅓ % SHR.

TYPICAL 1/2 SECTION
SHOWING BASE COURSE LIFTS
STA. 304+00 TO 305+50
STA. 320+00 TO 323+75
STA. 345+00 TO 349+00

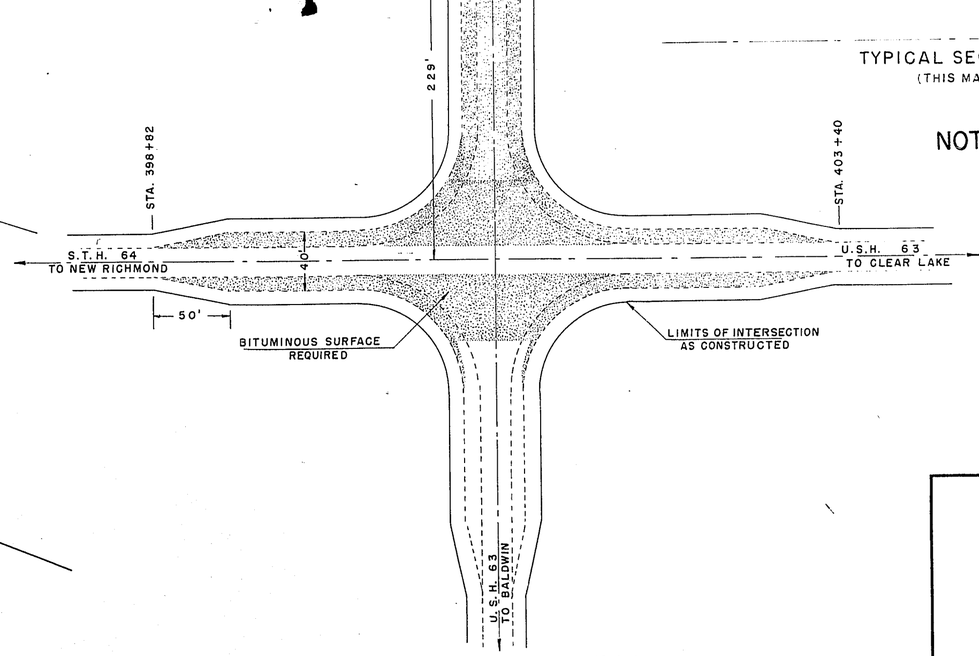

DETAIL OF INTERSECTION
STA. 401+11

NOTE: SHEET NOS. 4 - 27 ARE INCLUDED TO SHOW PROFILE AND ALIGNMENT ONLY. OTHER INFORMATION NOT PERTINENT TO THIS CONTRACT.

TYPICAL CROSS SECTION
FOR

BITUMINOUS RE SURFACE